

UTILITY NOTE:

1) UTILITIES SHOWN HEREON ARE DERIVED FROM RECORD PLANS AND FIELD OBSERVATIONS MADE BY ALPHA SURVEY BETWEEN MARCH 9 & 24, 2023.

2) ALL UNDERGROUND UTILITIES SHOWN ARE APPROXIMATE ONLY. ACTUAL LOCATIONS MUST BE DETERMINED IN THE FIELD. BEFORE DESIGNING, EXCAVATING, BLASTING, INSTALLING, BACK FILLING, GRADING, PAVEMENT RESTORATION OR REPAIRING, ALL UTILITY COMPANIES, PUBLIC & PRIVATE, MUST BE NOTIFIED INCLUDING THOSE IN CONTROL OF UTILITIES NOT SHOWN ON THIS PLAN. SEE CHAPTER 370, ACTS OF 1963, MASSACHUSETTS. ALPHA SURVEY GROUP, LLC ASSUMES NO RESPONSIBILITY FOR DAMAGES INCURRED AS A RESULT OF UTILITIES OMITTED OR INACCURATELY SHOWN. BEFORE FUTURE CONNECTIONS, THE APPROPRIATE UTILITY ENGINEERING DEPARTMENTS MUST BE CONSULTED. CALL "DIG SAFE" AT 811.

NOTES:


1) THE INFORMATION SHOWN HEREON IS BASED ON AN ON-THE-GROUND SURVEY PERFORMED BETWEEN MARCH 9 & 24, 2023, BY ALPHA SURVEY GROUP, LLC.

2) THE HORIZONTAL DATUM FOR THIS PROJECT IS THE MASSACHUSETTS STATE PLANE COORDINATE SYSTEM REFERENCED TO THE NORTH AMERICAN DATUM OF 1983 (NAD83), CORRS ADJUSTMENT (NA2011/GEOD 18A) AS DETERMINED BY REDUNDANT GPS OBSERVATIONS MADE ON MARCH 24, 2023 UTILIZING OR MACORS REAL TIME NETWORK.


3) THE VERTICAL DATUM FOR THIS PROJECT IS REFERENCED TO THE NORTH AMERICAN VERTICAL DATUM OF 1988 (NAV88), CORRS ADJUSTMENT (NA2011/GEOD 18A) AS DETERMINED BY REDUNDANT GPS OBSERVATIONS MADE ON MARCH 24, 2023 UTILIZING OR MACORS REAL TIME NETWORK. A CLOSED DIFFERENTIAL LEVEL LOOP WAS PERFORMED BETWEEN THE CONTROL POINTS.

DRAWING LEGEND

	DRAIN LINE		SEWER LINE
	GAS METER		WATER METER
	WATER GATE		ELECTRIC METER
	FIRE HYDRANT		UTILITY POLE
	DRAIN MANHOLE		SEWER MANHOLE
	CATCH BASIN		CATCH BASIN (D FRAME)
	BOLLARD		TREE (SIZE INCHES)
	BUSH (SIZE FEET)		GAS LINE
	CONNECTION NOT OBSERVED		C.N.O.
	DRAIN LINE		STONE WALL
	SEWER LINE		WATER LINE
	OVERHEAD ELECTRIC		CHAIN LINK FENCE
	UTILITY POLE		CONC.
	BITUMINOUS		SPOT GRADE
	CATCH BASIN		DOOR SILL ELEVATION
	STONE BOUND		DRILL HOLE
	BENCHMARK		TRAVERSE (CONTROL) POINT
	SIGN		SIGN

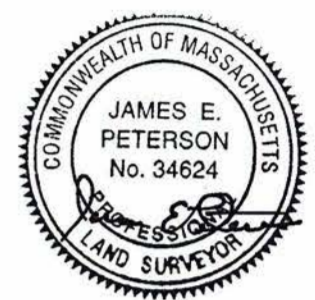

James E. Peterson
 REGISTERED PROFESSIONAL LAND SURVEYOR
 FOR ALPHA SURVEY GROUP, LLC
 DATE: 3/29/2023

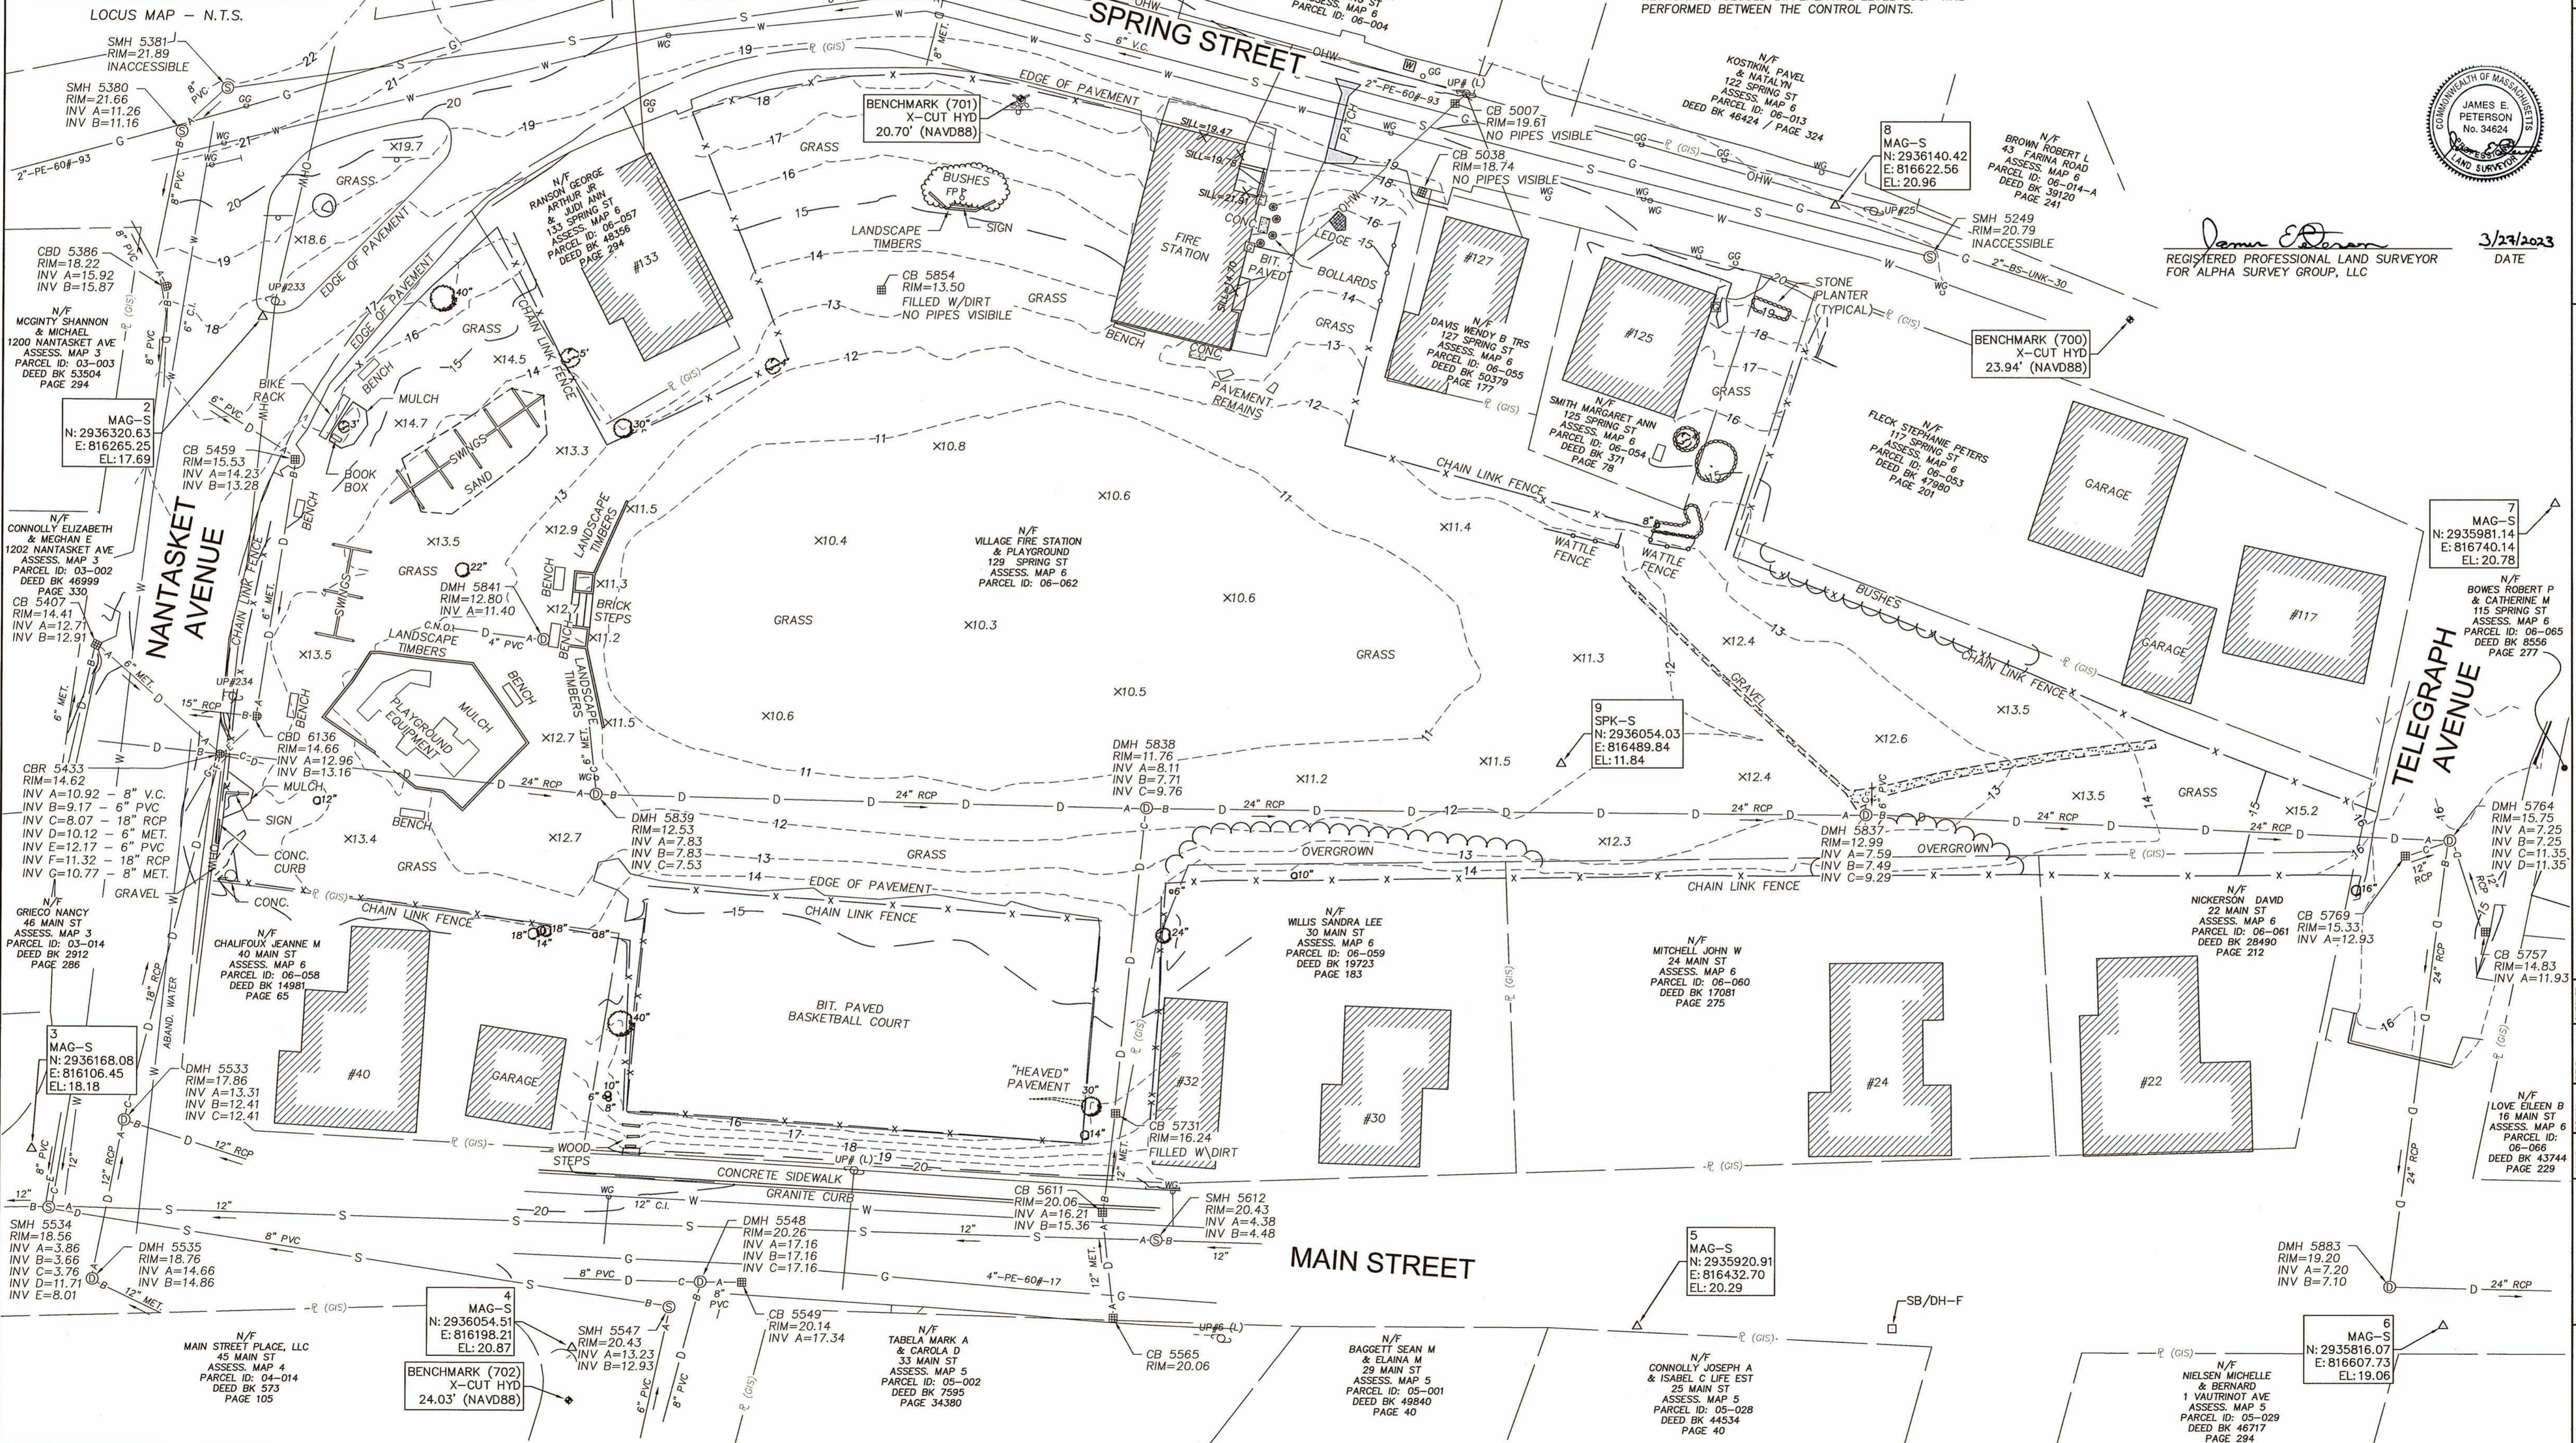

DATE	03/27/2023
JOB NO.	23110
SHEET NO.	1 of 1
DWG. NO.	23110_EC
PREPARED FOR	BETA PARK, INC. 315 NORWOOD PARK SOUTH 2ND FLOOR NORWOOD, MA 02062
VILLAGE PLAYGROUND	129 SPRING STREET HULL, MASSACHUSETTS
CHECKED	JD/PP/GA/JEP
FIELD	JD/PP/GA/JEP
SCALE	1"=20' GCA
PREPARED BY	ALPHA SURVEY GROUP, LLC 685 WAREHOUS STREET MIDDLEBOROUGH, MA 02346 T: (609) 295-5505 F: (609) 295-5585 WWW.ALPHASURVEY.COM